


68

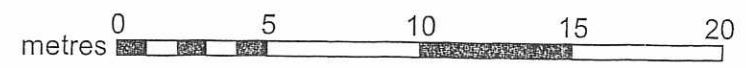

RECORD DRAWINGS

Hampshire
County Council

HCC Property Services,
Three Minsters House,
76 High Street, Winchester SO23 8UL.
tel: (01962) 847801

Notes	
1 This drawing is © copyright Hampshire County Council 2012. No unauthorised reproduction permitted. All rights reserved.	3 This map is reproduced from Ordnance Survey material with the permission of Ordnance Survey on behalf of the controller of Her Majesty's Stationery Office © Crown Copyright. Unauthorised reproduction infringes Crown Copyright and may lead to prosecution or civil proceedings. (100019180), (2012)
2 No dimensions are to be scaled from this drawing	

rev	description	date	by
A	Update plans following site survey.	25/09/13	CLW

PROJECT			
Hatch Warren Junior School			
Basingstoke, RG22 4PQ			
2761-10008001258			
SCALE	DATE	DRAWN.	CHKD.
1:125 @ A1	Dec 2006	CAD Cap	--
1:250 @ A3			

SHEET CONTENTS		
Property Records		
Ground Floor Plan		Property Services
Sheet 3 of 3		
DRAWING No.	01_Rec/003	REVISION
FILE REF.	2761-10008001258-HatchWarrenJuniorSchool.dwg	